


Key Plan - 1st Floor

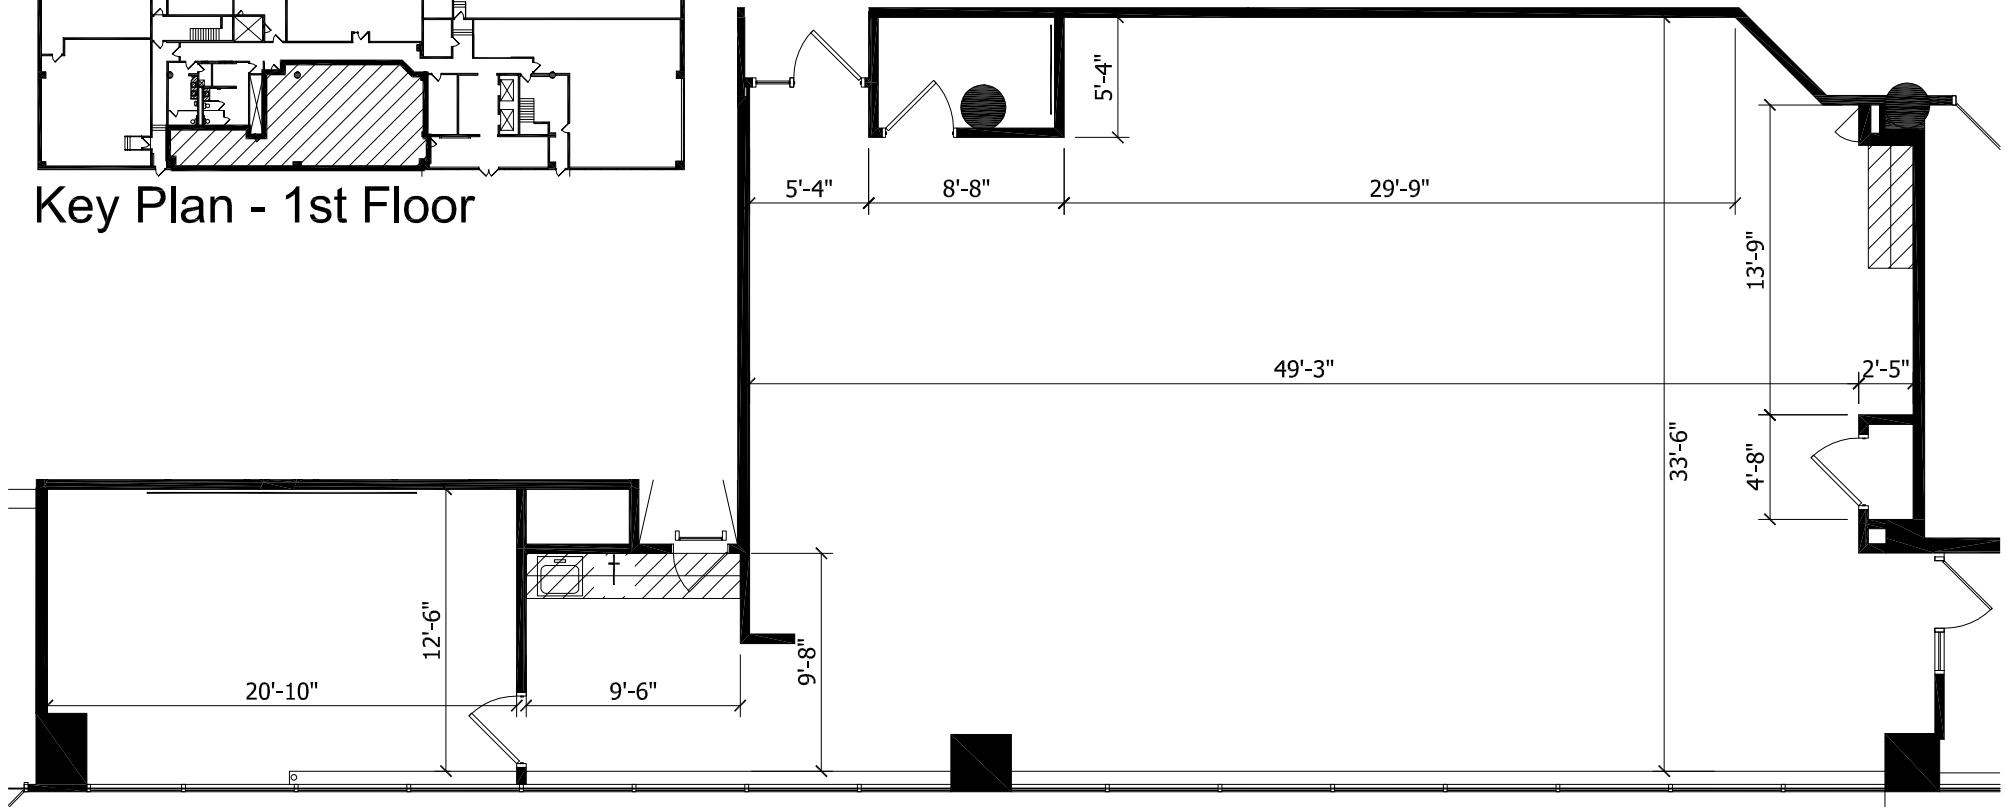

Client: Normandale Place - 8201 Norman Center Dr. Bloomington, MN 55437

Scale: Not To Scale

Sheet No.:

Project: As-Built Plan - Suite 100 (2,556 RSF)

Date: 04/24/20

# AB-100

Proj. No.: 06.02515.00

Drawn By: CMD