NELSON

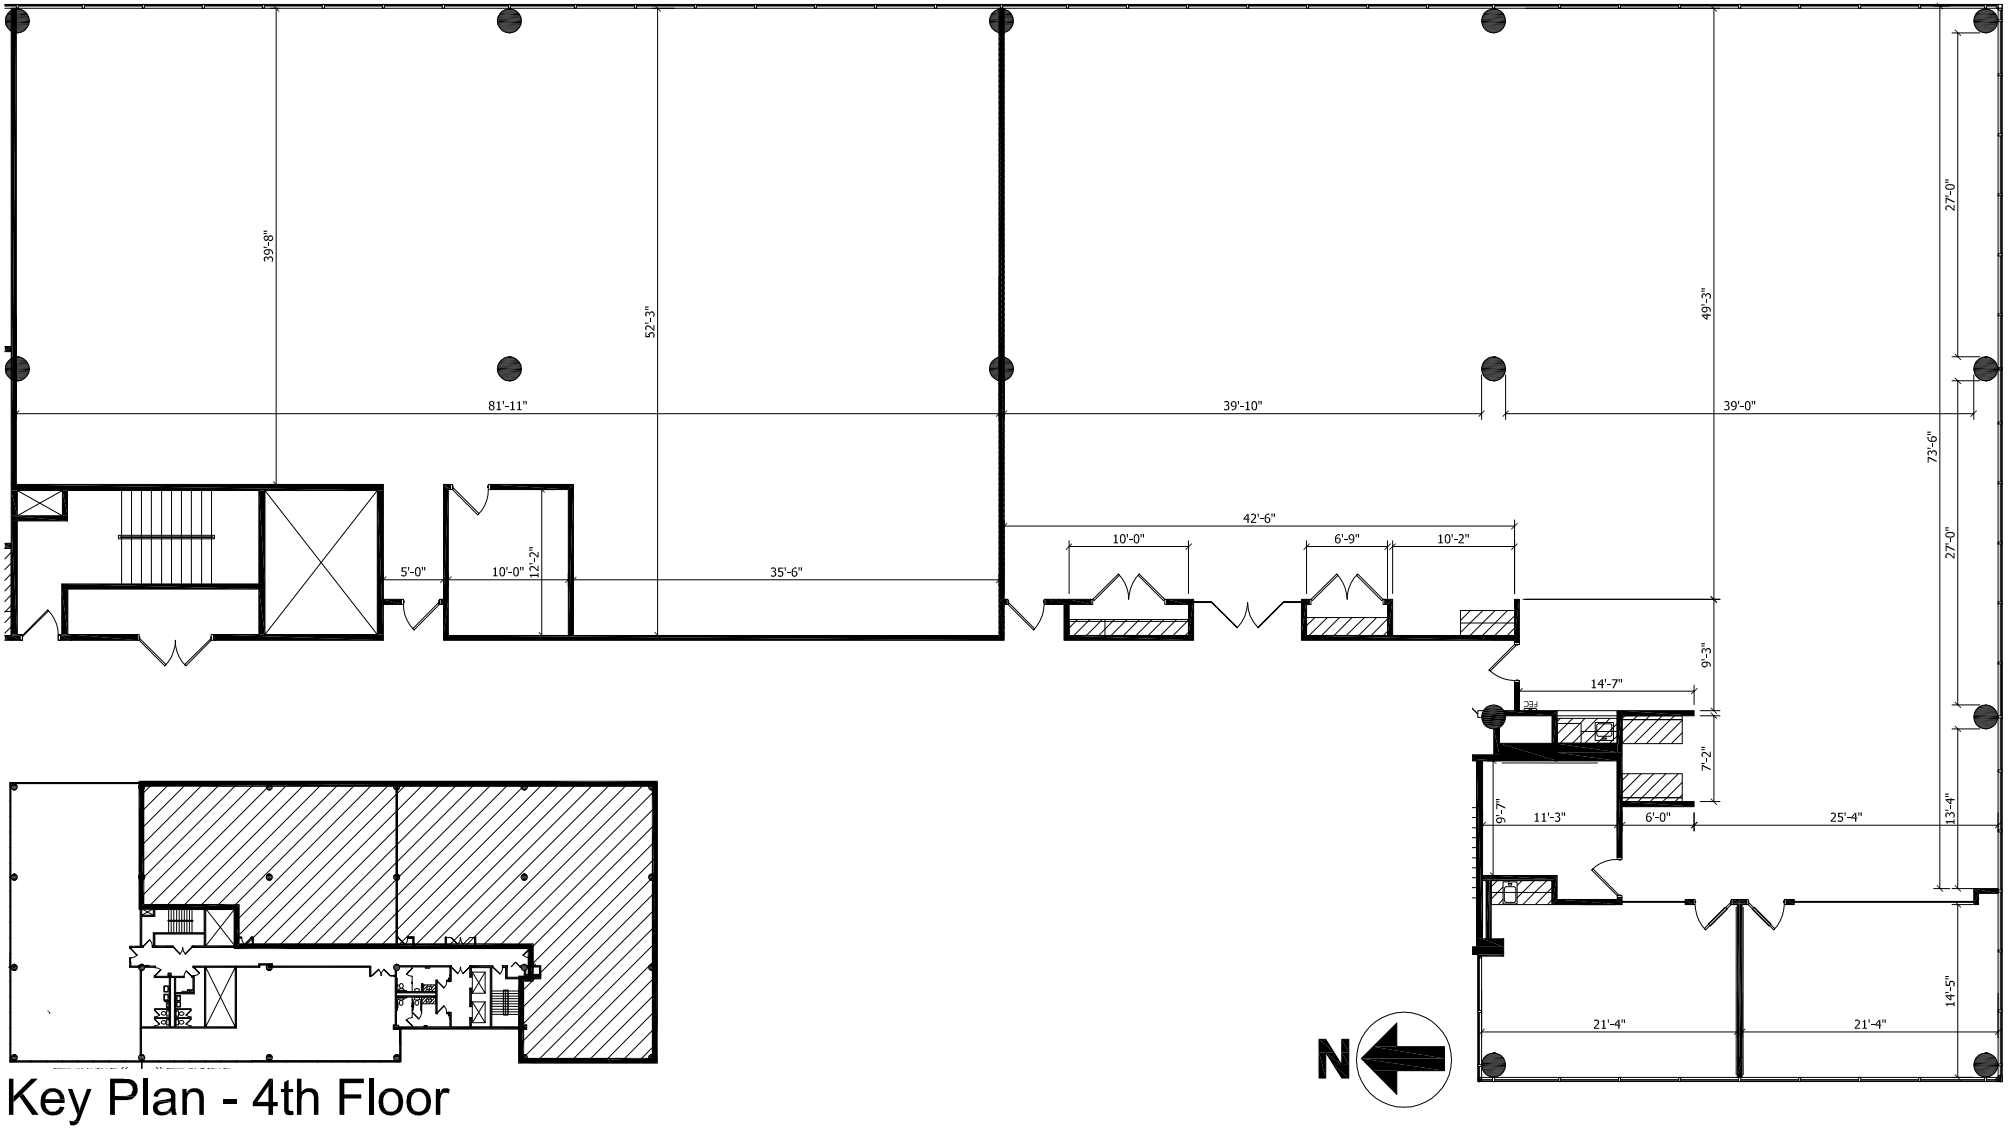

Key Plan - 4th Floor

Client:	Normandale Place - 8201 Norman Center Dr. Bloomington, MN 55437	Scale:	Not To Scale	Sheet No.:	AB-04
Project:	As-Built Plan - Suites 400 & 410 (11,463 RSF)	Date:	04/24/20		
Proj. No.:	19.01538.00	Drawn By:	CMD		